

LABOR AND MATERIALS

Copper	} Connection	_____	\$ _____	
Lead				
Curb	} Cock } Valve } T. S. & V.	_____ in.	\$ _____	
Service box		} Short 3½ x 4½ } Long 4½ x 5½		
Old returned				\$ _____
Ft. 3/4 in.	} Copper } G. I. } G. I.	Pipe at _____	\$ _____	
Nipples _____ in.		at _____	\$ _____	
Bushings _____ to _____ in.	at _____	\$ _____		
Red'g } Inc'g }	} Coupl'gs _____ to _____ in.	at _____	\$ _____	
Union _____ in.		at _____	\$ _____	
Meter _____ in.	at _____	\$ _____		
_____			\$ _____	
Compound Joints _____			\$ _____	
Maintenance Foreman _____			\$ _____	
Hrs. Water Maint. Man—1 at _____			\$ _____	
Hrs. Water Maint. Man—2 at _____			\$ _____	
Hrs. Garage Foreman _____ at _____			\$ _____	
Hrs. Labor— _____ at _____			\$ _____	
Hrs. Compressor at _____			\$ _____	
_____			\$ _____	
Trucking _____			\$ _____	
Pav't Patch _____			\$ _____	
_____			\$ _____	
_____			\$ _____	
_____			\$ _____	
_____			\$ _____	

FRANKLIN


St. Pl. No. 13
Ave. No.

Name of Owner

TAX ID # 309.16-8-10

Labor and Mat'l. Report

19-73

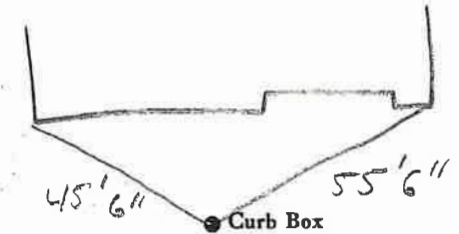

Main

Elev. of Main at tap _____

Gate at ●

● Gate at

● Curb Box