

LABOR AND MATERIALS

Copper } Connection		\$	
Lead } Connection		\$	
Curb } Cock	} in.	\$	
Curb } Valve			
	T. S. & V.		
Service box } Short 3½ x 4½	}	\$	
Old returned } Long 4½ x 5½			
Ft. 3/4 in. } Copper	} Pipe at	\$	
			G.I.
			C.I.
Nipples	in. at	\$	
Bushings	to in. at	\$	
Red'g } Coupl'gs	} to in. at	\$	
Ine'g }			
Union	in. at	\$	
Meter	in. at	\$	
		\$	
Compound Joints	at	\$	
Maintenance Foreman		\$	
Hrs. Water Maint. Man—1	at	\$	
Hrs. Water Maint. Man—2	at	\$	
Hrs. Garage Foreman	at	\$	
Hrs. Labor	at	\$	
Hrs. Compressor	at	\$	
		\$	
Trucking		\$	
Pav't Patch		\$	
		\$	
		\$	
		\$	
		\$	

FRANKLIN


St. ~~11~~  
Ave. No. 15

Name of Owner

JAMES KING

Labor and Mat'l. Report

1993

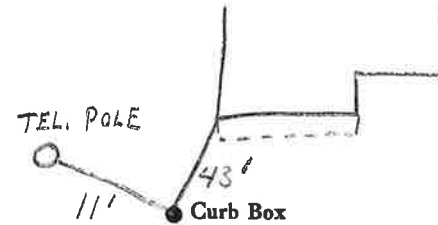

Main	Elev. of Main at tap
Gate at ●	● Gate at
	● Curb Box