


LABOR AND MATERIALS

Copper	Lead	Connection		\$	
Curb	Cock Valve T. S. & V.	}	in.	\$	
Service box Old returned	}	Short 3 1/2 x 4 1/2		\$	
		Long 4 1/2 x 5 1/2			
Ft.	3/4 in.	{ Copper G.I. C.I. }	Pipe at	\$	
Nipples	in.	at		\$	
Bushings	to	in.	at	\$	
Red'g Inc'g	}	Coupl'gs	to	in.	at
Union			in.	at	\$
Meter	in.	at		\$	
Compound Joints at				\$	
Maintenance Foreman				\$	
Hrs. Water Maint. Man—1 at				\$	
Hrs. Water Maint. Man—2 at				\$	
Hrs. Garage Foreman at				\$	
Hrs. Labor— at				\$	
Hrs. Compressor at				\$	
Trucking				\$	
Pav't Patch				\$	
				\$	
				\$	
				\$	
				\$	

St. FRANKLIN
 Ave. No. 16

Name of Owner _____

Labor and Mat'l. Report 1993

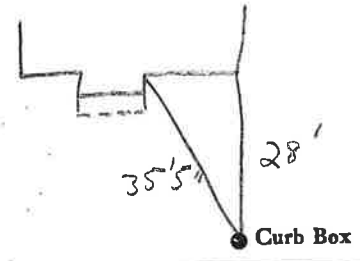

	Elev. of
Main	Main at tap
Gate at ●	● Gate at

● Curb Box