

LABOR AND MATERIALS


Copper	} Connection	_____	\$ _____	
Lead				
Curb	} Cock Valve T. S. & V. }	_____ in.	\$ _____	
Service box		} Short 3½ x 4½ } Long 4½ x 5½ }	_____	\$ _____
Old returned				\$ _____
Ft. ^{3/4} in.	} Copper } } G. I. } } G. I. }	Pipe at _____	\$ _____	
Nipples		_____ in. at _____	\$ _____	
Bushings	_____ to _____ in. at _____	\$ _____		
Red'g } Inc'g }	} Coupl'gs. _____ to _____ in. at _____	\$ _____		
Union		_____ in. at _____	\$ _____	
Meter	_____ in. at _____	\$ _____		
Compound Joints	at _____	\$ _____		
Maintenance Foreman	_____	\$ _____		
Hrs. Water Maint. Man—1	at _____	\$ _____		
Hrs. Water Maint. Man—2	at _____	\$ _____		
Hrs. Garage Foreman	at _____	\$ _____		
Hrs. Labor—	at _____	\$ _____		
Hrs. Compressor	at _____	\$ _____		
Trucking	_____	\$ _____		
Pav't Patch	_____	\$ _____		
		\$ _____		
		\$ _____		
FRANKLIN St. Pl. Ave. No. 17

Name of Owner

Labor and Mat'l. Report

19 93

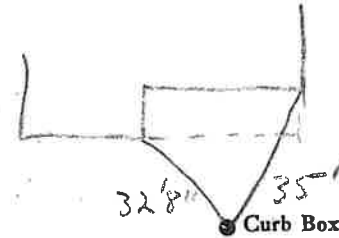

Main Elev. of Main at tap

Gate at • Gate at

• Curb Box