


LABOR AND MATERIALS

Copper	}	Connection	\$	
Lead				
Curb	}	Cock	in.	\$
		Valve		
		T. S. & V.		
Service box	}	Short 3½ x 4½		\$
		Long 4½ x 5½		
Old returned				
Ft. <u>¾</u> in.	}	Copper	Pipe at	\$
		G.I.		
		C.I.		
Nipples	in. at		\$	
Bushings	to in. at		\$	
Red'g	}	Coupl'gs	to in. at	\$
Inc'g				
Union	in. at		\$	
Meter	in. at		\$	
Compound Joints	at		\$	
Maintenance Foreman			\$	
Hrs. Water Maint. Man—1	at		\$	
Hrs. Water Maint. Man—2	at		\$	
Hrs. Garage Foreman	at		\$	
Hrs. Labor	at		\$	
Hrs. Compressor	at		\$	
Trucking			\$	
Pav't Patch			\$	
			\$	
			\$	
St. FRANKLIN
 Pt. 18
 Ave. No. 18

Name of Owner _____

Labor and Mat'l. Report 1944

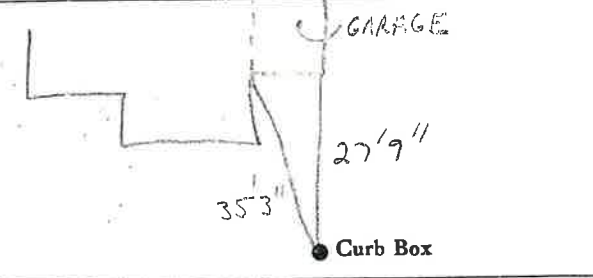

Main Elev. of
Main at tap

Gate at ● ● Gate at

● Curb Box