


LABOR AND MATERIALS

Copper	} Connection		\$	
Lead				
Curb	} Cock Valve T. S. & V.	in.	\$	
Service box		} Short 3 1/2 x 4 1/2 Long 4 1/2 x 5 1/2		
Old returned				\$
Ft.	} Copper <del>C.I.</del> <del>C.I.</del>	3/4 in. Pipe at	\$	
Nipples		in. at	\$	
Bushings	to in. at	\$		
Red'g	} Coupl'gs	to in. at	\$	
Inc'g				
Union	in. at	\$		
Meter	in. at	\$		
Compound Joints	at	\$		
Maintenance Foreman		\$		
Hrs. Water Maint. Man—1	at	\$		
Hrs. Water Maint. Man—2	at	\$		
Hrs. Garage Foreman	at	\$		
Hrs. Labor—	at	\$		
Hrs. Compressor	at	\$		
Trucking		\$		
Pav't Patch		\$		
		\$		
		\$		
St. FRANKLIN Ave. No. 20

Name of Owner

Labor and Mat'l. Report 19 93

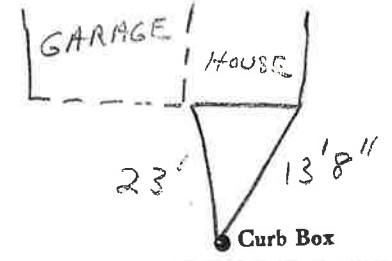

Main Elev. of Main at tap Gate at Gate at

Curb Box