


LABOR AND MATERIALS

1	Copper } Connection	3/4"	\$
1	Lead } Curb	3/4" in.	\$
1	Service box } Old returned	{ Short 3-1/2 x 4-1/2 Long 4-1/2 x 5-1/2 }	\$
20	Ft. } Copper	3/4" in. } Pipe at	\$
	Nipples	in. at	\$
	Bushings	to in. at	\$
	Red'g		
	Inc'g		
	Union	in. at	\$
	Meter	in. at	\$
			\$
	Compound Joints at		\$
	Maintenance Foreman		\$
	Hrs. Water Maint. Man - 1 at		\$
	Hrs. Water Maint. Man - 2 at		\$
	Hrs. Garage Foreman	at	\$
	Hrs. Labor	at	\$
	Hrs. Compressor at		\$
			\$
	Trucking		\$
	Pav't Patch		\$
			\$
			\$
FREDELLA Ave. No. 19
Name of Owner

Labor and Mat'l. Report 19 35, JULY 24

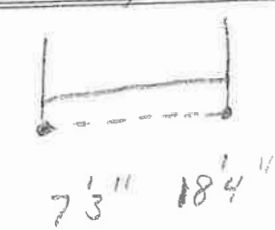

● Curb Box

6" Main Elev. of Main at tap 5'
Gate at ● Gate at

TAX ID # 310.5-3-4

● Curb Box

OLD TAP SHUT OFF AT MAIN