


LABOR AND MATERIALS

1	Copper	} Connection <sup>3/4"</sup>	\$
1	Lead		\$
1	Curb	} Cock Valve } <sup>3/4"</sup> in. Same,	\$
1	Same		T.S. & V.
1	Service box	} Short 3 1/2 x 4 1/2 } Long 4 1/2 x 5 1/2 }	\$
1	Old returned		Buff or Rdway
25	Ft. <sup>3/4"</sup> in.	} Copper } G.I. } Pipe at	\$
			C.I.
	Nipples	in. at	\$
	Bushings	to in. at	\$
	Red'g } Inc'g }	Coupl'gs to in. at	\$
	Union	in. at	\$
	Meter	in. at	\$
	Lead Joints	at	\$
	Compound Joints	at	\$
	Maintenance Foreman		\$
	Hrs. Water Maint. Man-1	at	\$
	Hrs. Water Maint. Man-2	at	\$
	Hrs. Garage Foreman	at	\$
	Hrs. Labor	at	\$
	Hrs. Compressor	at	\$
	Compensation Ins. at \$	per C	\$
	Trucking		\$
	Pav't Patch		\$
	Tap by LaRose Co.		\$
	9-13-71		\$
	O'head		\$
			\$

St. \_\_\_\_\_  
Pl. \_\_\_\_\_  
Ave. No. 23

Fredella  
Name of Owner  
Nunzio Pepe

Labor and Mat'l. Report Sept. 13 1971

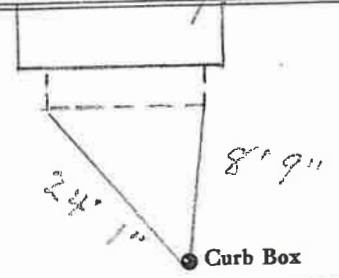

6" Main Elev. of Main at tap 4 1/2'

Gate at • Gate at •

TAX ID # 310.5-3-2

• Curb Box