


### Labor and Materials

1	Copper- Lead	Connection	5"			\$
1	Curb	Cock Valve T. G. & V.	3/4"	in		\$
1	Service Box -Old-retained	Short 3 1/2 x 4 1/2 Long 4 1/2 x 5 1/2 Buff. or Rdway				\$
4	Ft.	3/4 in.	Copper Galv Iron Cast-Iron	Pipe at		\$
	Nipples			in. at		\$
	Bushings			to in. at		\$
	Red'g Inc'g	Conplings		to in. at		\$
	Union			in. at		\$
	Meter			in. at		\$
	Lead Joints			at		\$
	Leadite Joints			at		\$
	Hrs. Foreman			at		\$
	Hrs. Chauffeur			at		\$
	Hrs. Tapper			at		\$
	Hrs. Labor			at		\$
	Hrs. Labor			at		\$
	Hrs. Compressor			at		\$
	Compensation Ins.					\$
	Trucking					\$
	Builders Use of Water					\$
						\$
						\$
St: 26  
 Pt: 3  
 Ave. No. 3

Fredella  
 Name of Owner  
*Finch Pump & Co.*

Labor and Mat'l. Report 10/27 1970

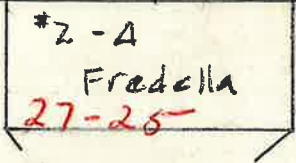

TAP is for  
vacant lot.

● Curb Box

6 Main Elev. of  
Main at tap 4

Gate at ● ● Gate at

● Curb Box