

LABOR AND MATERIALS

1 Copper } Connection  $\frac{3}{4}$ " \$  
 Lead }  
 1 Curb } Cock }  $\frac{3}{4}$ " Oriseal \$  
           } Valve }  
           } T.S. & V. }  
 1 Service box } Short  $3\frac{1}{2}$  x  $4\frac{1}{2}$  }  $5' \times 6'$  \$  
 Old returned } Long  $4\frac{1}{2}$  x  $5\frac{1}{2}$  }  
                   } Buff or Rdway }  
 8 Ft.  $\frac{3}{4}$  in. } Copper } Pipe at \$  
                   } C.I. }  
                   } C.I. }  
 Nipples in. at \$  
 Bushings to in. at \$  
 Red'g }  
 Inc'g } Coupl'gs to in. at \$  
 Union in. at \$  
 Meter in. at \$  
 Lead Joints at \$  
 Compound Joints at \$  
 Maintenance Foreman \$  
 Hrs. Water Maint. Man—1 at \$  
 Hrs. Water Maint. Man—2 at \$  
 Hrs. Garage Foreman at \$  
 Hrs. Labor at \$  
 Hrs. Compressor at \$  
 Compensation Ins. at \$ per C \$  
 Trucking \$  
 Pav't Patch \$  
 Tap by Gifford & Co. \$  
                   5-23-67. \$  
 O'head \$  
 \$

Fredella


St. \_\_\_\_\_  
 Pl. \_\_\_\_\_  
 Ave. No. 8

Name of Owner

Vincenzo D. Emilio

Labor and Mat'l. Report

May 23 1967

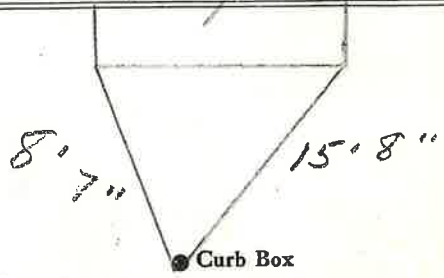

6" Main

Elev. of Main at tap  $6\frac{1}{2}$ '

Gate at ●

● Gate at

● Curb Box