


Labor and Materials

1	Copper Lead	Connection	3/4"		\$
1	Curb	Cock Valve	3/4"	in	\$
1	Service Box	Short	3 1/2 x 4 1/2	?	\$
	Old returned	Long	4 1/2 x 5 1/2	1	\$
6	Ft.	3/4" in.		Pipe at	\$
	Nipples	in. at			\$
	Bushings	to		in. at	\$
	Red'g In'g	Conplings	to	in. at	\$
	Union	in. at			\$
	Meter	in. at			\$
	Lead Joints	at			\$
	Leadite Joints	at			\$
	Hrs. Foreman	at			\$
	Hrs. Chauffeur	at			\$
	Hrs. Tapper	at			\$
	Hrs. Labor	at			\$
	Hrs. Labor	at			\$
	Hrs. Compressor	at			\$
	Compensation Ins.				\$
	Trucking				\$
	Builders Use of Water				\$
	Tap La Rose Cons. Co.				\$
	9-17-71				\$
					\$
					\$

St. 16
Pt. 9 1/2
Ave. No.

Name of Owner De Santis

Labor and Mat'l. Report Sept. 17 1971

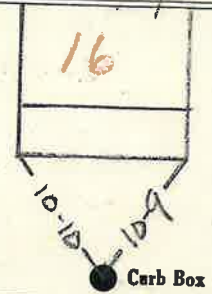

6 Main Elev. of Main at tap 5

Gate at ● Gate at

● Curb Box