

LABOR AND MATERIALS

1	Copper Lead	Connection	3/4		\$ 2.87
1	Curb	Cock Valve T. S. & V.	3/4 in.		\$ 3.67
	Service box	Short 3 1/2 X 4 1/2		same	—
	Old returned	Long 4 1/2 X 5 1/2			
2.5	Ft. 3/4 in.	Copper G.I. Pipe	at 32		\$ 8.00
	Nipples	in. at			\$
	Bushings	to in. at			\$
	Red'g Inc'g	Coupl'gs to in. at			\$
	Union	in. at			\$
	Meter	in. at			\$
	Lead Joints	at			\$
	Compound Joints	at			\$
5	Hrs. Water Maint. Man—1	at 1.12			\$ 5.60
7	Hrs. Water Maint. Man—2	at 1.02			\$ 7.14
15	Hrs. Labor—	at 91			\$ 13.65
	Hrs. Labor—	at			\$
	Hrs. Compressor	at			\$
	Compensation Ins. at \$ 2.50	per C			\$ 0.58
	Trucking				\$ 3.00
	Pav't Patch				\$
	Tap by Miller				\$
	O'head				\$
					\$ 43.46

72

St. Fulton
Pl-
Ave. No. 13

Name of Owner
Plumley

Labor and Mat'l. Report June 27 1949

38'7" 21'-3"

● Curb Box

10 Main Elev. of Main at tap 5

Gate at ● ● Gate at

● Curb Box

17 ho Billed ✓

LSM-5C B 18-48

LABOR AND MATERIALS

Copper	} Connection	_____	\$ _____
Lead			
Curb	} Cock	_____	\$ _____
		} Valve	_____ in. _____
			T. S. & V.
Service box	} Short 3 1/2 x 4 1/2	_____	\$ _____
Old returned		Long 4 1/2 x 5 1/2	
21 Ft.	} Copper	} Pipe at _____	\$ _____
_____ in.			G. I.
			G. I.
Nipples	_____ in. at _____	\$ _____	
Bushings	_____ to _____ in. at _____	\$ _____	
Red'g	} Coupl'gs _____ to _____ in. at _____	\$ _____	
Inc'g			
Union	_____ in. at _____	\$ _____	
Meter	_____ in. at _____	\$ _____	
Compound Joints	_____ at _____	\$ _____	
Maintenance Foreman	_____	\$ _____	
Hrs. Water Maint. Man-1	_____ at _____	\$ _____	
Hrs. Water Maint. Man-2	_____ at _____	\$ _____	
Hrs. Garage Foreman	_____ at _____	\$ _____	
Hrs. Labor	_____ at _____	\$ _____	
Hrs. Compressor	_____ at _____	\$ _____	
Trucking	_____	\$ _____	
Pav't Patch	_____	\$ _____	
		\$ _____	
		\$ _____	

FULTON

St. _____
 Pt. _____
 Ave. No. 13

Name of Owner _____

Labor and Mat'l. Report

1924

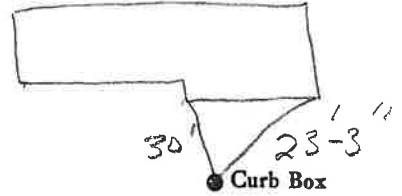

10 Main

Elev. of Main at tap 4

Gate at •

• Gate at

• Curb Box

LABOR AND MATERIALS

_____	Copper } Connection _____	\$ _____
_____	Lead } _____	\$ _____
_____	Curb } Cock _____	\$ _____
_____	Valve } _____ in. _____	\$ _____
_____	T.S. & V. } _____	\$ _____
_____	Service box { Short 3-1/2 x 4-1/2 } _____	\$ _____
_____	Old returned { Long 4-1/2 x 5-1/2 } _____	\$ _____
_____	Ft. _____ in. { Copper } Pipe at _____	\$ _____
_____	G.I. } _____	\$ _____
_____	C.I. } _____	\$ _____
_____	Nipples _____ in. at _____	\$ _____
_____	Bushings _____ to _____ in. at _____	\$ _____
_____	Red'g _____	\$ _____
_____	Inc'g _____	\$ _____
_____	Union _____ in. at _____	\$ _____
_____	Meter _____ in. at _____	\$ _____
_____	_____	\$ _____
_____	Compound Joints at _____	\$ _____
_____	Maintenance Foreman _____	\$ _____
_____	Hrs. Water Maint. Man - 1 at _____	\$ _____
_____	Hrs. Water Maint. Man - 2 at _____	\$ _____
_____	Hrs. Garage Foreman _____ at _____	\$ _____
_____	Hrs. Labor _____ at _____	\$ _____
_____	Hrs. Compressor at _____	\$ _____
_____	_____	\$ _____
_____	Trucking _____	\$ _____
_____	Pav't Patch _____	\$ _____
_____	_____	\$ _____
_____	_____	\$ _____
FULTON St. No. 13

Name of Owner _____

Labor and Mat'l. Report # 3/2012

