

LABOR AND MATERIALS

1 Copper } Connection $\frac{3}{4}$ \$ _____
~~base~~
 1 Curb } Cock Valve } $\frac{3}{4}$ in. \$ _____
 T.S. & V. }
 1 Service box { Short 3-1/2 x 4-1/2 } \$ _____
 Old returned { Long 3-1/2 x 4-1/2 }
 10 Ft. $\frac{3}{4}$ in. { Copper } Pipe at \$ _____
 Nipples _____ in. at \$ _____
 Bushings _____ to _____ in. at \$ _____
 Red'g _____
 Inc'g _____
 Union _____ in. at \$ _____
 Meter _____ in. at \$ _____
 _____ \$ _____
 Compound Joints at \$ _____
 Maintenance Foreman \$ _____
 Hrs. Water Maint. Man - 1 at \$ _____
 Hrs. Water Maint. Man - 2 at \$ _____
 Hrs. Garage Foreman _____ at \$ _____
 Hrs. Labor _____ at \$ _____
 Hrs. Compressor at \$ _____
 _____ \$ _____
 Trucking \$ _____
 Pav't Patch \$ _____
 _____ \$ _____
 _____ \$ _____
 _____ \$ _____
 _____ \$ _____


FULTON

St.

Ass. No. 2

Name of Owner

Labor and Mat'l. Report 1928, DEC. 10

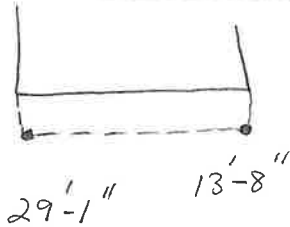

● Curb Box

10" Main

Elev. of Main at tap $4\frac{1}{2}$

Gate at ●

● Gate at

● Curb Box

OLD LEAD DISCONNECTED