

LABOR AND MATERIALS


1 Copper } Connection $\frac{3}{4}$ _____ \$ _____
 1 Curb } Cock valve } $\frac{3}{4}$ in. _____ \$ _____
 1 Service box { Short 3-1/2 x 4-1/2 } _____ \$ _____
 Old returned { Long 4-1/2 x 5-1/2 } _____ \$ _____
 9 Ft. $\frac{3}{4}$ in. { Copper } Pipe at _____ \$ _____
 _____ Nipples _____ in. at _____ \$ _____
 _____ Bushings _____ to _____ in. at _____ \$ _____
 _____ Red'g _____
 _____ Inc'g _____
 _____ Union _____ in. at _____ \$ _____
 _____ Meter _____ in. at _____ \$ _____
 _____ _____ \$ _____
 _____ Compound Joints at _____ \$ _____
 _____ Maintenance Foreman _____ \$ _____
 _____ Hrs. Water Maint. Man - 1 at _____ \$ _____
 _____ Hrs. Water Maint. Man - 2 at _____ \$ _____
 _____ Hrs. Garage Foreman _____ at _____ \$ _____
 _____ Hrs. Labor _____ at _____ \$ _____
 _____ Hrs. Compressor at _____ \$ _____
 _____ _____ \$ _____
 _____ Trucking _____ \$ _____
 _____ Pav't Patch _____ \$ _____
 _____ _____ \$ _____
 _____ _____ \$ _____
 _____ _____ \$ _____
 _____ _____ \$ _____

FULTON

St. Ave. No. 24

Name of Owner
TAX ID # 302.16-21-20

Labor and Mat'l. Report 1934, OCT. 8

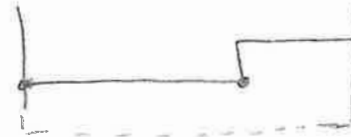

39-6 31-3

● Curb Box

10" Main

Elev. of Main at tap 52'

Gate at ●

● Gate at

● Curb Box

OLD TAP SHUT OFF AT
MAIN