

LABOR AND MATERIALS


1	Copper Lead	Connection	$\frac{3}{4}$		\$	2.87
1	Curb	Cock Valve	$\frac{3}{4}$	in.	\$	3.62
1	Service box	Short	$3\frac{1}{2} \times 4\frac{1}{2}$		\$	4.68
	Old returned	Long	$4\frac{1}{2} \times 5\frac{1}{2}$		\$	
		Buffer	Rdway		\$	
14	Ft.	Copper		Pipe at	\$	4.48
	$\frac{3}{4}$				\$	
	Nipples			in. at	\$	
	Bushings			to in. at	\$	
	Red'g				\$	
	Inc'g	Coupl'gs		to in. at	\$	
	Union			in. at	\$	
	Meter			in. at	\$	
	Lead Joints			at	\$	
	Compound Joints			at	\$	
4	Hrs.	Water Maint. Man—1		at	\$	4.42
4	Hrs.	Water Maint. Man—2		at	\$	4.03
8	Hrs.	Labor—		at	\$	7.28
	Hrs.	Labor—		at	\$	
	Hrs.	Compressor at			\$	
	Compensation Ins.	at \$ 2.12		per C	\$	0.25
	Trucking				\$	2.00
	Pav't Patch				\$	
	Tap by Miller				\$	
	O'head				\$	
					\$	33.84

73

St. FULTON
 Tr. Ave. No. 28

Name of Owner TRhodes

Labor and Mat'l. Report Jan 23 1949

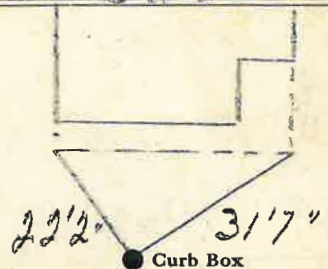

18 Main Elev. of Main at tap 5'

Gate at ● Gate at ●

TAX ID # 302.16-21-22

● Curb Box