

### LABOR AND MATERIALS

1	Copper Lead	Connection	3/4	\$ 2.87	
1	Curb	Cock Valve T. S. & V.	3/4 in.	\$ 3.62	
1	Service box	Short 3 1/2 X 4 1/2			
	Old returned	Long 4 1/2 X 6 1/2			
		Buffer Rdway		\$ 4.68	
26	Ft.	Copper Pipe at	3/4 in. 32	\$ 8.32	
	Nipples	in. at		\$	
	Bushings	to in. at		\$	
	Red'g				
	Inc'g	Coupl'gs to in. at		\$	
	Union	in. at		\$	
	Meter	in. at		\$	
	Lead Joints	at		\$	
	Compound Joints	at		\$	
5	Hrs. Water Maint. Man-1	at	1.12	\$ 5.60	
7	Hrs. Water Maint. Man-2	at	1.02	\$ 7.14	
15	Hrs. Labor	at	9.1	\$ 17.65	
	Hrs. Labor	at		\$	
	Hrs. Compressor	at		\$	
	Compensation Ins.	at \$ 2.00 per C.		\$ 0.59	
	Trucking			\$ 2.00	
	Pav't Patch			\$	
	Tap by <i>Morgan</i>			\$	
	O'head			\$	
				\$ 48.46	


75

FULTON

St.   
 ~~St.~~   
 Ass. No. 31

Name of Owner   
 *Murphy*

Labor and Mat'l. Report *June 23* 1949

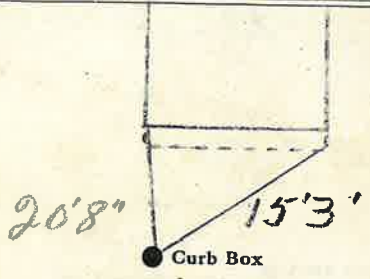

10" Main Elev. of Main at tap 5'

Gate at ● ● Gate at

● Curb Box

LSM-5C 5 15-48

*To be Billed*

