

### LABOR AND MATERIALS


Copper Lead	Connection	3/4			\$ 1.23
1 Curb	Cock Valve T. S. & V.	3/4	in.		\$ 1.68
1 Service Box	Old returned	Short 3 1/2 x 4 1/2	}	Pipe at 17	\$ 1.54
		Long 4 1/2 x 5 1/2			
9 Ft.		3/4	in.		
		Copper	}	Pipe at 17	\$ 1.53
		Galv Iron			
		Cast Iron			
Nipples	in. at				\$
Bushings	to in. at				\$
Red'g Inc'g	Couplings	to	in. at		\$
Union	in. at				\$
Meter	in. at				\$
Lead Joints	at				\$
Leadite Joints	at				\$
Hrs. Foreman	at				\$
3	Hrs. Chauffeur	6 2 1/2			\$ 1.88
1	Hrs. Tapper	2			\$ .62
8	Hrs. Labor	45			\$ 3.60
	Hrs. Labor				\$
1	Hrs. Compressor	6 2 1/2			\$ .63
	Compensation Ins.				\$ .19
	Trucking				\$ 1.00
	Builders Use of Water	Patch			\$ 5.00
	Top by Power				\$
					\$
					\$
					\$ 18.90

10 1 - 1939

St. Fulton  
 Ph.             
 Ave. No. 34

Name of Owner Knowles

Labor and Mat'l. Report NOV 30 1939

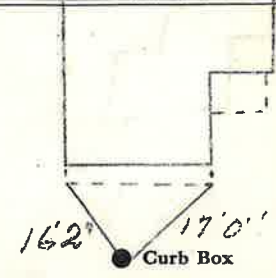

10 Main Elev. of Main at top 4 1/2

Gate at ● ● Gate at

● Curb Box

*old to be done in Dec 1939*