

LABOR AND MATERIALS

Copper	} Connection		\$	
Lead				
Curb	} Cock } Valve } T. S. & V. }	in.	\$	
Service box		} Short 3½ x 4½ } Long 4½ x 5½ }		
Old returned				\$
21 Ft. 2 in.	} Copper } C.I. } C.I. }	Pipe at	\$	
Nipples		in. at	\$	
Bushings	to	in. at	\$	
Red'g Inc'g	} Coupl'gs	to	in. at	
Union		in. at	\$	
Meter	in. at	\$		
Compound Joints	at	\$		
Maintenance Foreman		\$		
Hrs. Water Maint. Man-1	at	\$		
Hrs. Water Maint. Man-2	at	\$		
Hrs. Garage Foreman	at	\$		
Hrs. Labor	at	\$		
Hrs. Compressor	at	\$		
Trucking		\$		
Pav't Patch		\$		
		\$		
		\$		
		\$		
		\$		

FULTON


St. 3 1/2
Pl.
Ave. No.

Name of Owner

FEIGENBAUM CLEANERS

Labor and Mat'l. Report

Apr 19 2000

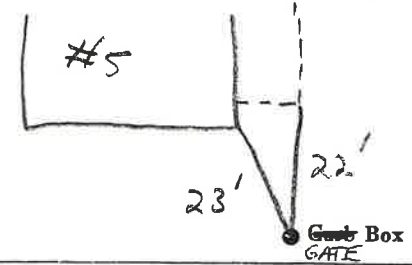

10" Main

Elev. of Main at tap

Gate at ●

● Gate at

● Curb Box