

LABOR AND MATERIALS

Copper	}	Connection			\$		
Lead							
Curb	}	Cock Valve T. S. & V.			\$		
Service Box			}	Short 3 1/2 x 4 1/2 Long 4 1/2 x 5 1/2 Buff. or Rdway			\$
Old returned							
Ft.	}			\$			
		}			\$		
		}			\$		
Nipples		in. at			\$		
Bushings		to in. at			\$		
Red'g Inc'g	}	Couplings	to in. at		\$		
Union			in. at		\$		
Meter		in. at		\$			
Lead Joints		at		\$			
Leadite Joints		at		\$			
Hrs. Foreman		at		\$			
Hrs. Chauffeur		at		\$			
Hrs. Tapper		at		\$			
Hrs. Labor		at		\$			
Hrs. Labor		at		\$			
Hrs. Compressor		at		\$			
Compensation Ins.				\$			
Trucking				\$			
Builders Use of Water				\$			
				\$			
				\$			
St.
Pt. Fulton
Ave. No. 5

Name of Owner _____


Labor and Mat'l. Report

1912



● Curb Box

11-12-26
8 FULTON

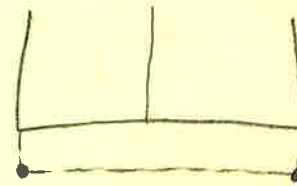

20'8" 23'