


GAGE

Ave. No. 5

Name of Owner

Labor and Mat'l. Report 1923, OCT. 8

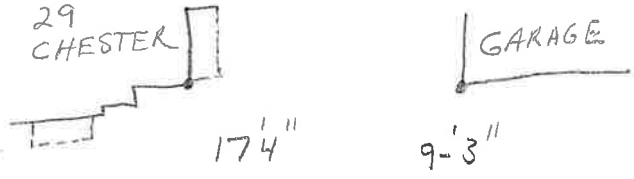

● Curb Box

4" Main

Elev. of Main at tap 6'

Gate at ●

● Gate at

● Curb Box

4/19/2001 #5 GAGE

SEWER REPAIR.

WATER IS NEXT TO SEWER.

### LABOR AND MATERIALS

1	Copper Lead	Connection	$\frac{3}{4}$ "	\$	_____
1	Curb Valve	Cock Valve	1" in.	\$	_____
1	Service box	Short 3-1/2 x 4-1/2		\$	_____
	Old returned	Long 4-1/2 x 5-1/2		\$	_____
17	Ft. 1" in.	Copper G.I. Pipe		\$	_____
	Nipples		in. at	\$	_____
	Bushings		to in. at	\$	_____
	Red'g				_____
	Inc'g				_____
	Union		in. at	\$	_____
	Meter		in. at	\$	_____
				\$	_____
	Compound Joints			\$	_____
	Maintenance Foreman			\$	_____
	Hrs. Water Maint. Man - 1		at	\$	_____
	Hrs. Water Maint. Man - 2		at	\$	_____
	Hrs. Garage Foreman		at	\$	_____
	Hrs. Labor		at	\$	_____
	Hrs. Compressor		at	\$	_____
				\$	_____
	Trucking			\$	_____
	Pav't Patch			\$	_____
				\$	_____
				\$	_____
				\$	_____
				\$	_____