


LABOR AND MATERIALS

- 1 Copper } Connection $\frac{3}{4}$ \$ _____
- 1 Lead } _____ \$ _____
- 1 Curb } Cock } $\frac{3}{4}$ in. \$ _____
- 1 T.S. & V. } _____ \$ _____
- 1 Service box { Short $3\frac{1}{2} \times 4\frac{1}{2}$ } \$ _____
- 1 Old returned { Long $4\frac{1}{2} \times 5\frac{1}{2}$ } \$ _____
- 13 Ft. $\frac{3}{4}$ in. { Copper } Pipe at \$ _____
- _____ Nipples _____ in. at \$ _____
- _____ Bushings _____ to _____ in. at \$ _____
- _____ Red'g _____
- _____ Inc'g _____
- _____ Union _____ in. at \$ _____
- _____ Meter _____ in. at \$ _____
- _____ \$ _____
- _____ Compound Joints at \$ _____
- _____ Maintenance Foreman \$ _____
- _____ Hrs. Water Maint. Man - 1 at \$ _____
- _____ Hrs. Water Maint. Man - 2 at \$ _____
- _____ Hrs. Garage Foreman _____ at \$ _____
- _____ Hrs. Labor _____ at \$ _____
- _____ Hrs. Compressor at \$ _____
- _____ \$ _____
- _____ Trucking _____ \$ _____
- _____ Pav't Patch _____ \$ _____
- _____ \$ _____
- _____ \$ _____
GAGE Ave. No. 23AB

Name of Owner HARRY KEENAN

Labor and Mat'l. Report 1937, MAY 7

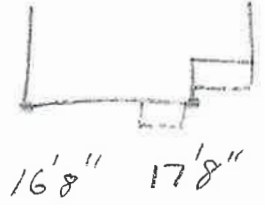

● Curb Box

4" Main Elev. of Main at tap $5\frac{1}{2}'$

Gate at ● Gate at

TAX ID # 302.16-12-30

● Curb Box

OLD SHUT OFF