

**LABOR AND MATERIALS**


1 ~~Lead~~ } Copper } Connection \_\_\_\_\_ \$ \_\_\_\_\_  
 1 Curb } Cock } \_\_\_\_\_ in. \_\_\_\_\_ \$ \_\_\_\_\_  
       } Valve }  
       } T.S. & V. }  
 1 Service box { Short 3-1/2 x 4-1/2 } \_\_\_\_\_ \$ \_\_\_\_\_  
   Old returned { Long 4-1/2 x 5-1/2 }  
 12 Ft. <sup>3</sup>/<sub>4</sub> in. { Copper } Pipe at \_\_\_\_\_ \$ \_\_\_\_\_  
                   }           }  
 \_\_\_\_\_ Nipples \_\_\_\_\_ in. at \_\_\_\_\_ \$ \_\_\_\_\_  
 1 Bushings <sup>3</sup>/<sub>4</sub> to <sup>1</sup>/<sub>2</sub> in. at \_\_\_\_\_ \$ \_\_\_\_\_  
 \_\_\_\_\_ Red'g \_\_\_\_\_ \$ \_\_\_\_\_  
 \_\_\_\_\_ Inc'g \_\_\_\_\_ \$ \_\_\_\_\_  
 \_\_\_\_\_ Union \_\_\_\_\_ in. at \_\_\_\_\_ \$ \_\_\_\_\_  
 \_\_\_\_\_ Meter \_\_\_\_\_ in. at \_\_\_\_\_ \$ \_\_\_\_\_  
 \_\_\_\_\_ \$ \_\_\_\_\_  
 \_\_\_\_\_ Compound Joints at \_\_\_\_\_ \$ \_\_\_\_\_  
 \_\_\_\_\_ Maintenance Foreman \_\_\_\_\_ \$ \_\_\_\_\_  
 \_\_\_\_\_ Hrs. Water Maint. Man - 1 at \_\_\_\_\_ \$ \_\_\_\_\_  
 \_\_\_\_\_ Hrs. Water Maint. Man - 2 at \_\_\_\_\_ \$ \_\_\_\_\_  
 \_\_\_\_\_ Hrs. Garage Foreman \_\_\_\_\_ at \_\_\_\_\_ \$ \_\_\_\_\_  
 \_\_\_\_\_ Hrs. Labor \_\_\_\_\_ at \_\_\_\_\_ \$ \_\_\_\_\_  
 \_\_\_\_\_ Hrs. Compressor at \_\_\_\_\_ \$ \_\_\_\_\_  
 \_\_\_\_\_ \$ \_\_\_\_\_  
 \_\_\_\_\_ Trucking \_\_\_\_\_ \$ \_\_\_\_\_  
 \_\_\_\_\_ Pav't Patch \_\_\_\_\_ \$ \_\_\_\_\_  
 \_\_\_\_\_ \$ \_\_\_\_\_  
 \_\_\_\_\_ \$ \_\_\_\_\_  
GARFIELD

St. \_\_\_\_\_  
 Ave. No. 17

Name of Owner  
 TAX D # 302.19-19-10

Labor and Mat'l. Report 1931, APR. 23

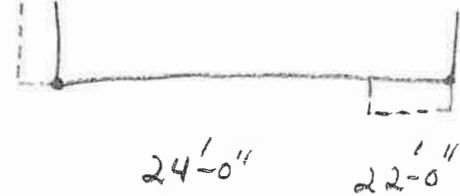

6" Main

Elev. of Main at tap 5'

Gate at ● Gate at ●

12' to main

3/4" copper

● Curb Box