

LABOR AND MATERIALS

Copper	}	Connection.....	\$	
Lead					
Curb	{	Cock Valve T. S. & V. { in.	\$
Service Box Old returned					
22 Ft. ³⁴ in.	}	Copper Galv Iron Cast Iron	Pipe at.....	\$	
Nipples.....					in. at.....
Bushings.....	to.....	in. at.....	\$		
Red'g Inc'g	}	Couplings.....	to.....	in. at.....	\$
Union.....					
Meter.....	in. at.....	\$			
Lead Joints at.....	\$				
Leadite Joints at.....	\$				
Hrs. Foreman at.....	\$				
Hrs. Chauffeur at.....	\$				
Hrs. Tapper at.....	\$				
Hrs. Labor at.....	\$				
Hrs. Labor at.....	\$				
Hrs. Compressor at.....	\$				
Compensation Ins.	\$				
Trucking.....	\$				
Builders Use of Water.....	\$				
.....	\$				
.....	\$				

St.
Pl.
Ave. No. 26

Garfield

Name of Owner

TAP MADE FEB. 18, 1930

Labor and Mat'l. Report AUG 24 1939 19

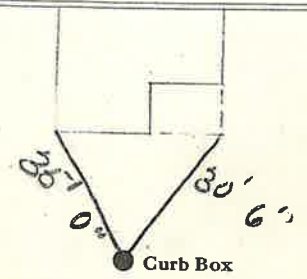

6¹¹ Main

Elev. of
Main at tap 4¹

Gate at ● Gate at ●

● Curb Box