


LABOR AND MATERIALS

1 Copper } Connection $\frac{3}{4}$ \$ _____
 1 Curb } Cock Valve } $\frac{3}{4}$ in. \$ _____
 1 Service box { Short 3-1/2 x 4-1/2 } \$ _____
 Old returned { Long 4-1/2 x 5-1/2 } \$ _____
 23 Ft. $\frac{3}{4}$ in. { Copper } Pipe at \$ _____
 Nipples _____ in. at \$ _____
 1 Bushings $\frac{3}{4}$ to $\frac{1}{2}$ in. at \$ _____
 Red'g _____
 Inc'g _____
 Union _____ in. at \$ _____
 Meter _____ in. at \$ _____
 Compound Joints at \$ _____
 Maintenance Foreman \$ _____
 Hrs. Water Maint. Man - 1 at \$ _____
 Hrs. Water Maint. Man - 2 at \$ _____
 Hrs. Garage Foreman _____ at \$ _____
 Hrs. Labor _____ at \$ _____
 Hrs. Compressor at \$ _____
 Trucking \$ _____
 Pav't Patch \$ _____
 \$ _____
 \$ _____
St. GARFIELD
 Ave. No. 32

Name of Owner _____

Labor and Mat'l. Report 19 28, APR. 18

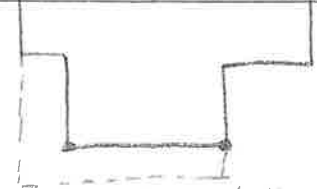

29'5" 26'8"

● Curb Box

6" Main Elev. of Main at tap 4'

Gate at ● Gate at ●

● Curb Box

OLD TAP SHUT OFF