


LABOR AND MATERIALS

_____	Copper } Connection _____	\$ _____
_____	Lead } _____	\$ _____
_____	Curb } Cock _____	\$ _____
_____	Valve } _____ in. _____	\$ _____
_____	T.S. & V. } _____	\$ _____
_____	Service box { Short 3-1/2 x 4-1/2 }	\$ _____
_____	Old returned { Long 4-1/2 x 5-1/2 }	\$ _____
_____	Ft. <u>3/4</u> in. { Copper } Pipe at _____	\$ _____
_____	Nipples _____ in. at _____	\$ _____
_____	Bushings _____ to _____ in. at _____	\$ _____
_____	Red'g _____	\$ _____
_____	Inc'g _____	\$ _____
_____	Union _____ in. at _____	\$ _____
_____	Meter _____ in. at _____	\$ _____
_____	_____	\$ _____
_____	Compound Joints at _____	\$ _____
_____	Maintenance Foreman _____	\$ _____
_____	Hrs. Water Maint. Man - 1 at _____	\$ _____
_____	Hrs. Water Maint. Man - 2 at _____	\$ _____
_____	Hrs. Garage Foreman _____ at _____	\$ _____
_____	Hrs. Labor _____ at _____	\$ _____
_____	Hrs. Compressor at _____	\$ _____
_____	_____	\$ _____
_____	Trucking _____	\$ _____
_____	Pav't Patch _____	\$ _____
_____	_____	\$ _____
_____	_____	\$ _____
_____	_____	\$ _____
_____	_____	\$ _____

St. _____
GARFIELD Ave. No. 50-52

Name of Owner _____

Labor and Mat'l. Report 19 30, JUNE

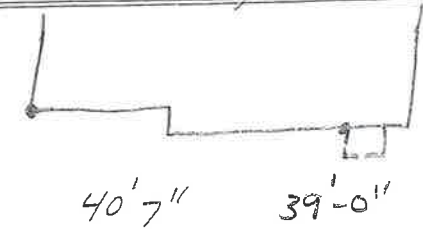

● Curb Box

_____ Main Elev. of Main at tap _____

Gate at ● Gate at ●

● Curb Box

Labor and Materials

1	Lead Connection	\$
1	Curb Cock	\$
	Service Box { Short 3 1/2 x 4 1/2	\$
	Old returned { Long 4 1/2 x 5 1/2	\$
	{ Buffalo	\$
2.8	Ft. in. G. I. Pipe at	\$
	Nipples in. at	\$
	Bushings to in. at	\$
	Red'g Coup to in. at	\$
	Inc'g Coup to in. at	\$
	Union in. at	\$
	Meter in. at	\$
	Cu. Yds. Br. Stone at	\$
	Cu. Yds. Sand at	\$
	Bags Cement at	\$
	Paving Brick { Mack	\$
	{ Red	\$
	{ Asphalt } at	\$
4	Hrs. Foreman at	\$
11	Hrs. Common Labor at	\$
	Hrs. Mason at	\$
	Hrs. at	\$
	Hrs. at	\$
gn	Builders' Use of Water	\$
	at	\$
	Truck 1.00	\$
	at	\$
	at	\$
	at	\$
	at	\$
	Total	\$ 16.62

Labor and Material Report

Nov 19 19

50 52
1/2" tap at



5052

Curb Box

6 Main

Elev. of Main at tap 48

Gate at ●

● Gate at

Curb Box