

LABOR AND MATERIALS

1	Copper	Connection	\$	
	Lead			
1	Curb	Cock	in.	\$
		Valve		
		Tap		
	Service box	Short 3 1/2 x 4 1/2		\$
	Old returned	Long 4 1/2 x 5 1/2		
		Buff or Redway		
6	Ft. 1"	Copper	Pipe at	\$
		G. I.		
		C.I.		
	Nipples	in.	at	\$
	Bushings	to	in. at	\$
	Red'g			
	Inc'g	Coupl'gs.	to in. at	\$
	Union	in.	at	\$
	Meter	in.	at	\$
	Lead Joints at			\$
	Compound Joints at			\$
	Maintenance Foreman			\$
	Hrs. Water Maint. Man-1	at		\$
	Hrs. Water Maint. Man-2	at		\$
	Hrs. Garage Foreman	at		\$
	Hrs. Labor	at		\$
	Hrs. Compressor at			\$
	Compensation Ins. at \$	per C		\$
	Trucking			\$
	Pav't Patch			\$
	measured in by			
	DORRAN &			
	Larreau.			
	O'head	9-	63.	\$
				\$


INSTALLED MAY, 1924

57

Garfield St. Ave. No. 45

Name of Owner J. Gruber.

measured in Labor and Mat'l. Report - Sept. 19 65

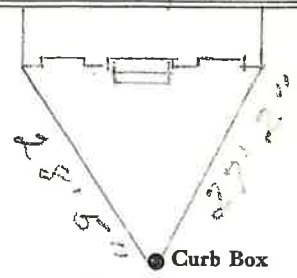

Main Elev. of Main at tap

Gate at • Gate at

6' to main

• Curb Box