


LABOR AND MATERIALS

Copper } Connection _____ \$ _____
 Lead }
 Curb } Cock _____ in. _____ \$ _____
 } Valve _____
 } T.S. & V. _____
 Service box { Short 3-1/2 x 4-1/2 } _____ \$ _____
 Old returned { Long 4-1/2 x 5-1/2 } _____
 Ft. _____ in. { Copper } Pipe at _____ \$ _____
 } G.I.
 } C.I.
 Nipples _____ in. at _____ \$ _____
 Bushings _____ to _____ in. at _____ \$ _____
 Red'g _____
 Inc'g _____
 Union _____ in. at _____ \$ _____
 Meter _____ in. at _____ \$ _____
 _____ \$ _____
 Compound Joints at _____ \$ _____
 Maintenance Foreman _____ \$ _____
 Hrs. Water Maint. Man - 1 at _____ \$ _____
 Hrs. Water Maint. Man - 2 at _____ \$ _____
 Hrs. Garage Foreman _____ at _____ \$ _____
 Hrs. Labor _____ at _____ \$ _____
 Hrs. Compressor at _____ \$ _____
 _____ \$ _____
 Trucking _____ \$ _____
 Pav't Patch _____ \$ _____
 _____ \$ _____
 _____ \$ _____
GARFIELD St **59**
 Pl. No. _____
 Ave. No. _____
 Name of Owner _____

MEASURED
 Labor and Mat'l. Report ~~XX~~ **JUNE 12, 2002**

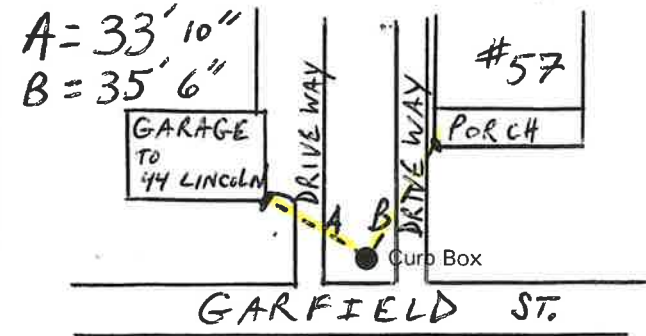

Main _____ Elev. of Main at tap _____
 Gate at ● _____ Gate at ● _____
 — NO LONGER IN SERVICE —
 ● Curb Box

THIS CURB BOX IS NOT
 IN SERVICE. CURB BOX
 FOR LOT #59 WAS
 DISCONNECTED FROM MAIN
 JUNE 12TH 2002. BY T. MISSITA