


# LABOR AND MATERIALS

_____	Copper } Connection	_____	\$ _____
_____	Lead } _____	_____	\$ _____
_____	Curb } Cock	_____ in.	\$ _____
_____	_____ } Valve	_____	\$ _____
_____	_____ } T.S. & V.	_____	\$ _____
_____	Service box { Short 3-1/2 x 4-1/2	_____	\$ _____
_____	Old returned { Long 4-1/2 x 5-1/2	_____	\$ _____
26	Ft. 3/4 in. { Copper } Pipe at	_____	\$ _____
_____	Nipples _____ in. at	_____	\$ _____
_____	Bushings _____ to _____ in. at	_____	\$ _____
_____	Red'g _____	_____	\$ _____
_____	Inc'g _____	_____	\$ _____
_____	Union _____ in. at	_____	\$ _____
_____	Meter _____ in. at	_____	\$ _____
_____	_____	_____	\$ _____
_____	Compound Joints at	_____	\$ _____
_____	Maintenance Foreman _____	_____	\$ _____
_____	Hrs. Water Maint. Man - 1 at	_____	\$ _____
_____	Hrs. Water Maint. Man - 2 at	_____	\$ _____
_____	Hrs. Garage Foreman _____ at	_____	\$ _____
_____	Hrs. Labor _____ at	_____	\$ _____
_____	Hrs. Compressor at	_____	\$ _____
_____	_____	_____	\$ _____
_____	Trucking _____	_____	\$ _____
_____	Pav't Patch _____	_____	\$ _____
_____	_____	_____	\$ _____
_____	_____	_____	\$ _____
St. GARFIELD 64  
 No. 64

Name of Owner \_\_\_\_\_

Labor and Mat'l. Report 1923, OCT. 27

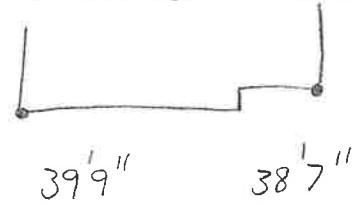

● Curb Box

6" Main

Elev. of Main at tap 4'

Gate at ●

● Gate at

● Curb Box