


LABOR AND MATERIALS

Copper } Connection _____ \$
 Lead }
 Curb } Cock _____ in. _____ \$
 Valve }
 T.S. & V. }
 Service box { Short 3-1/2 x 4-1/2 } _____ \$
 Old returned { Long 4-1/2 x 5-1/2 } _____ \$
 25'6" Ft. 3/4" in. Copper } Pipe at _____ \$
 G.I. }
 C.I. }
 Nipples _____ in. at _____ \$
 Bushings _____ to _____ in. at _____ \$
 Red'g _____
 Inc'g _____
 Union _____ in. at _____ \$
 Meter _____ in. at _____ \$
 _____ \$
 Compound Joints at _____ \$
 Maintenance Foreman _____ \$
 Hrs. Water Maint. Man - 1 at _____ \$
 Hrs. Water Maint. Man - 2 at _____ \$
 Hrs. Garage Foreman _____ at _____ \$
 Hrs. Labor _____ at _____ \$
 Hrs. Compressor at _____ \$
 _____ \$
 Trucking _____ \$
 Pav't Patch _____ \$
 _____ \$
 _____ \$
GARFIELD St. No. 12
 Pt. Ave. No.

Name of Owner PACE BUILDERS

Labor and Mat'l. Report TO 8/29/2007

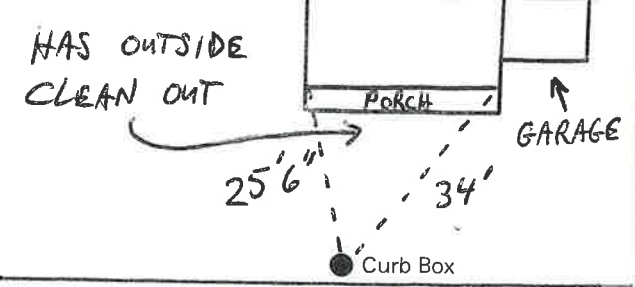

6" GROVE AVE Main Elev. of Main at tap 4 FEET

Gate at ● Gate at ●

● Curb Box

SEWER MAIN 16'5" FROM CURB BOX. SEWER MAIN IS 7' DEEP.