


LABOR AND MATERIALS

Copper } Connection		\$
Lead }		
Curb } Cock	} in.	\$
} Valve		
} T. S. & V.		
Service box { Short 3 1/2 x 4 1/2	}	\$
Old returned { Long 4 1/2 x 5 1/2		
} Buff or Rdway		
9 Ft. 3/4 in. { Copper	} Pipe at	\$
} C.I.		
Nipples	in. at	\$
Bushings	to in. at	\$
Red'g } Coupl'gs	to in. at	\$
Inc'g }		
Union	in. at	\$
Meter	in. at	\$
Lead Joints	at	\$
Compound Joints	at	\$
Maintenance Foreman		\$
Hrs. Water Maint. Man-1	at	\$
Hrs. Water Maint. Man-2	at	\$
Hrs. Garage Foreman	at	\$
Hrs. Labor	at	\$
Hrs. Compressor	at	\$
Compensation Ins. at \$	per C	\$
Trucking		\$
Pav't Patch		\$
		\$
		\$
		\$
O'head		\$
		\$

St. Pl  
 Ave. No. 38  
 Name of Owner Heer

Labor and Mat'l. Report Oct 12 1984

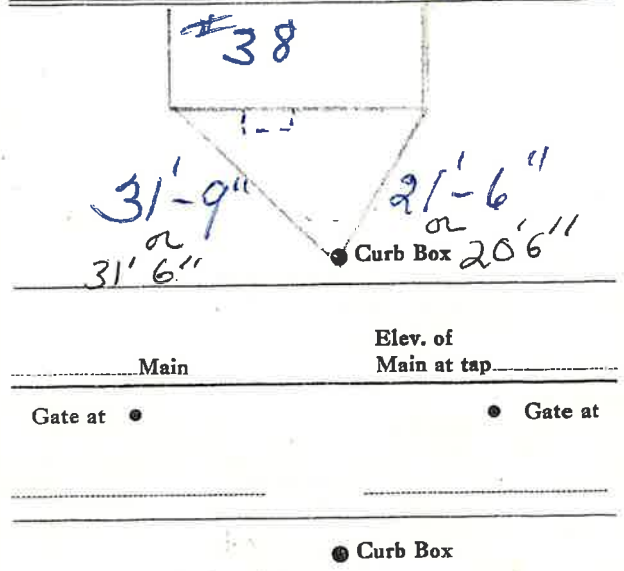

LABOR AND MATERIALS

1	Copper	{ Connection	3/4"	\$	3.04
1	Lead	{ Cock			
1	Curb	{ Valve	3/4 in.	\$	3.54
		{ F.S. & V.			
same	Service box	{ Short	3 1/2 x 4 1/2		
	Old returned	{ Long	4 1/2 x 5 1/2		
		{ Buff or Rdway		\$	
9	Ft. 3/4 in.	{ Copper			
		{ G.I.	Pipe at 35	\$	3.15
		{ C.I.			
	Nipples	in. at		\$	
	Bushings	to in. at		\$	
	Red'g	{ Coupl'gs	to in. at	\$	
	Ine'g				
	Union	in. at		\$	
	Meter	in. at		\$	
	Lead Joints	at		\$	
	Compound Joints	at		\$	
2	Hrs. Water Maint. Man-1	at 1.23		\$	2.69
3	Hrs. Water Maint. Man-2	at 1.13		\$	3.39
15	Hrs. Labor	at 1.02		\$	15.30
	Hrs. Labor	at		\$	
	Hrs. Compressor	at		\$	
	Compensation Ins. at \$2.66 per C.			\$	.57
	Trucking			\$	1.00
	Pav't Patch	B. Paving		\$	
	O'head			\$	
	Tap by Gifford			\$	32.69

7-10-51


107-1451

Geer

St. Pt. Ave. No. 38

Name of Owner  
Cohen & Son, Junk.

Labor and Mat'l. Report July 10 1951

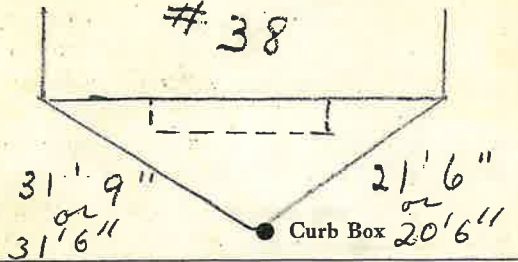

4" Main Elev. of Main at tap 4'  
Gate at ● Gate at ●

● Curb Box