

LABOR AND MATERIALS

1 Copper } Connection $\frac{1}{2}$ " \$
~~Iron~~ }
 1 Curb } Cock } $\frac{3}{4}$ in. (MARK II) \$ seal
~~Valve~~ }
~~Tap~~ }
 1 Service box } Short $3\frac{1}{2}$ x $4\frac{1}{2}$ } 3'
 Old returned } Long $4\frac{1}{2}$ x $5\frac{1}{2}$ }
 } Butt or Rdway }
 9 Ft. $\frac{3}{4}$ in. } Copper } Pipe at \$
~~Iron~~ }
 Nipples in. at \$
 Bushings to in. at \$
 Red'g }
 Inc'g } Coupl'gs to in. at \$
 Union in. at \$
 Meter in. at \$
 Lead Joints at \$
 1 Compound Joints at $\frac{3}{4}$ " BYPASS Elbow \$
 Maintenance Foreman \$
 Hrs. Water Maint. Man-1 at \$
 Hrs. Water Maint. Man-2 at \$
 Hrs. Garage Foreman at \$
 Hrs. Labor- at \$
 Hrs. Compressor at \$
 Compensation Ins. at \$ per C \$
 Trucking \$
 Pav't Patch \$
 TAP MADE BY GIFFORD & CO \$
 O'head DEC-21-1972 \$
 \$

Geer


St. Ave. No. 40

Name of Owner

Robt. Cunningham

Labor and Mat'l. Report

Dec 21 1972

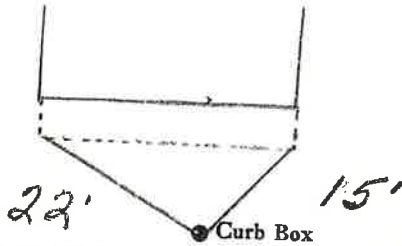

4" Main

Elev. of Main at tap 3'

Gate at ●

● Gate at

● Curb Box