


# LABOR AND MATERIALS

1 Copper } Connection 3/4 \$ \_\_\_\_\_  
~~head~~  
 1 Curb } Cock } 3/4 in. \$ \_\_\_\_\_  
           } Valve }  
           } T.S. & V. }  
 1 Service box { Short 3-1/2 x 4-1/2 } \$ \_\_\_\_\_  
 Old returned { Long 4-1/2 x 6-1/2 }  
 9 Ft. 3/4 in. { Copper } Pipe at \$ \_\_\_\_\_  
                   }           }  
 Nipples \_\_\_\_\_ in. at \$ \_\_\_\_\_  
 1 Bushings 3/4 to 1/2 in. at \$ \_\_\_\_\_  
 Red'g \_\_\_\_\_  
 Inc'g \_\_\_\_\_  
 Union \_\_\_\_\_ in. at \$ \_\_\_\_\_  
 Meter \_\_\_\_\_ in. at \$ \_\_\_\_\_  
 \_\_\_\_\_ \$ \_\_\_\_\_  
 Compound Joints at \_\_\_\_\_ \$ \_\_\_\_\_  
 Maintenance Foreman \_\_\_\_\_ \$ \_\_\_\_\_  
 Hrs. Water Maint. Man - 1 at \_\_\_\_\_ \$ \_\_\_\_\_  
 Hrs. Water Maint. Man - 2 at \_\_\_\_\_ \$ \_\_\_\_\_  
 Hrs. Garage Foreman \_\_\_\_\_ at \_\_\_\_\_ \$ \_\_\_\_\_  
 Hrs. Labor \_\_\_\_\_ at \_\_\_\_\_ \$ \_\_\_\_\_  
 Hrs. Compressor at \_\_\_\_\_ \$ \_\_\_\_\_  
 \_\_\_\_\_ \$ \_\_\_\_\_  
 Trucking \_\_\_\_\_ \$ \_\_\_\_\_  
 Pav't Patch \_\_\_\_\_ \$ \_\_\_\_\_  
 \_\_\_\_\_ \$ \_\_\_\_\_  
 \_\_\_\_\_ \$ \_\_\_\_\_  
 \_\_\_\_\_ \$ \_\_\_\_\_  
 \_\_\_\_\_ \$ \_\_\_\_\_

St. \_\_\_\_\_  
 No. 44  
GEER  
 Name of Owner \_\_\_\_\_

Labor and Mat'l. Report 19 27, OCT, 7

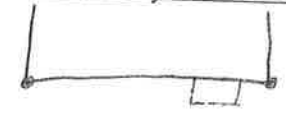

23'      26'

● Curb Box

4" Main      Elev. of Main at tap 4 1/2'

Gate at ●      ● Gate at

● Curb Box

OLD TAP SHUT OFF