

# LABOR AND MATERIALS


<u>1</u>	Copper } Connection	_____	\$ _____
<u>1</u>	Lead } Curb	_____	\$ _____
		Cock Valve } _____ in.	\$ _____
		J.S. & V. }	
<u>1</u>	Service box { Short 3-1/2 x 4-1/2	_____	\$ _____
	Old returned { Long 4-1/2 x 6-1/2	_____	\$ _____
<u>9</u>	Ft. <u>3/4</u> in. { Copper	_____	\$ _____
		} Pipe at _____	\$ _____
_____	Nipples _____	in. at _____	\$ _____
_____	Bushings _____	to _____ in. at _____	\$ _____
_____	Red'g _____		\$ _____
_____	Inc'g _____		\$ _____
_____	Union _____	in. at _____	\$ _____
_____	Meter _____	in. at _____	\$ _____
_____			\$ _____
_____	Compound Joints at _____		\$ _____
_____	Maintenance Foreman _____		\$ _____
_____	Hrs. Water Maint. Man - 1 at _____		\$ _____
_____	Hrs. Water Maint. Man - 2 at _____		\$ _____
_____	Hrs. Garage Foreman _____	at _____	\$ _____
_____	Hrs. Labor _____	at _____	\$ _____
_____	Hrs. Compressor at _____		\$ _____
_____			\$ _____
_____	Trucking _____		\$ _____
_____	Pav't Patch _____		\$ _____
_____			\$ _____
_____			\$ _____
GEER

St.   
 No. 48

Name of Owner   
 MRS. CATHERINE TOOMEY

Labor and Mat'l. Report 1925, OCT. 13

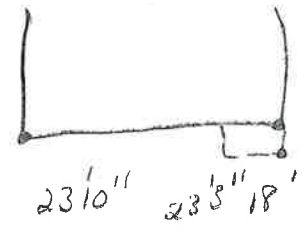

● Curb Box

\_\_\_\_\_ Main Elev. of Main at tap \_\_\_\_\_

Gate at ● ● Gate at

● Curb Box

OLD SHUT OFF