

### LABOR AND MATERIALS

1	Copper	Connection	3/4	\$ 1.35					
	Lead								
1	Curb	Cock Valve T.S. & V.	3/4 in.	\$ 1.88					
1	Service Box	Old returned	<table border="0" style="font-size: small;"> <tr> <td style="border-left: 1px solid black; padding-left: 5px;">Short 3 1/2 x 4 1/2</td> <td rowspan="3" style="font-size: 2em; vertical-align: middle;">}</td> <td rowspan="3" style="vertical-align: middle;">Buff. or Rdway</td> </tr> <tr> <td style="border-left: 1px solid black; padding-left: 5px;">Long 4 1/2 x 6 1/2</td> </tr> <tr> <td style="border-left: 1px solid black; padding-left: 5px;"> </td> </tr> </table>	Short 3 1/2 x 4 1/2	}	Buff. or Rdway	Long 4 1/2 x 6 1/2		\$ 1.82
Short 3 1/2 x 4 1/2	}	Buff. or Rdway							
Long 4 1/2 x 6 1/2									
12	Ft.	3/4 in.	Copper Galv. Iron Cast Iron	Pipe at 20 \$ 2.40					
	Nipples	in. at		\$					
	Bushings	to in. at		\$					
	Red'g Inc'g	Couplings	to in. at	\$					
	Union	in. at		\$					
	Meter	in. at		\$					
	Lead Joints	at		\$					
	Leadite Joints	at		\$					
	Hrs. Foreman	at		\$					
1	Hrs. Chauffeur	at	68 3/4	\$ .69					
7	Hrs. Tapper	at	5	\$ 4.81					
7	Hrs. Labor	at	55	\$ 3.85					
	Hrs. Labor	at		\$					
2	Hrs. Compressor	at	92	\$ 1.84					
	Compensation Ins.			\$ .29					
	Trucking			\$ 1-					
	Builders Use of Water	1/2 Patch (Sewer)		\$ 2.50					
	Tap by Hassel			\$					
				\$					
				\$					
				\$					
				\$ 22.43					

H.


9 1942

St. \_\_\_\_\_  
 Pt. \_\_\_\_\_  
 Ave. No. 7

Goop

Name of Owner  
 Tom O'Connor

Labor and Mat'l. Report 9/18 1942

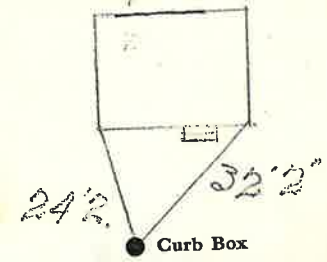

6" Main Elev. of Main at tap 5'  
 Gate at ● Gate at ●

● Curb Box