

Labor and Materials

1	Copper } Connection.....	$\frac{2}{4}$	\$ 2.60
	Lead }		
1	Curb } Cock Valve }	$\frac{3}{4}$ in.	\$ 2.27
1	Service Box } Short $3\frac{1}{2} \times 4\frac{1}{2}$ }		\$ 1.38
	Old returned } Long $5\frac{1}{2}$ }		
		Butt or Rdway	
32	Ft. $\frac{3}{4}$ in. } Copper } Pipe at.....		\$ 5.76
		Gate Iron	
		Cast Iron	
	Nipples.....	in. at.....	\$
	Bushings.....	to..... in. at.....	\$
	Red'g } Couplings.....	to..... in. at.....	\$
	Inc'g }		
	Union.....	in. at.....	\$
	Meter.....	in. at.....	\$
	Lbs. Br. Stone at.....		\$
	Lbs. Sand at.....		\$
	Bags Cement at.....		\$
	Paving Brick } Mack } at.....		\$
		Red	
		Asphalt	
	Lead Joints at.....		\$
	Leadite Joints at.....		\$
6	Hrs. Foreman at.....		\$ 3.75
14	Hrs. Common Labor at.....		\$ 6.30
	Hrs. Common Labor at.....		\$
	Hrs. Mason at.....		\$
	Hrs. Mason's Helper at.....		\$
	Hrs. Compressor at.....		\$
	Compensation Ins.....		\$ 31
	Trucking.....		\$ 1.00
	Builders' Use of Water.....	Patch	\$ 5.00
Total \$			28.37


31-185

Labor and Material Report

Oct

1 1931

37 Apr at

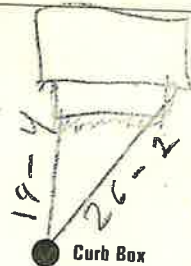

4 Main

Elev of Main at tap

Gate at ●

● Gate at

● Curb Box

Old top to be dug up