


# LABOR AND MATERIALS

1	Copper Lead } Connection		\$	
1	Curb } Cock Valve T.C. & V. } in.		\$	
	Service box } Short 3-1/2 x 4-1/2 } Old returned } Long 4-1/2 x 5-1/2 }		\$	
33	Ft. 3/4 in. } Copper G.I. } Pipe at		\$	
	Nipples	in. at	\$	
	Bushings	to in. at	\$	
	Red'g			
	Inc'g			
	Union	in. at	\$	
	Meter	in. at	\$	
			\$	
	Compound Joints at		\$	
	Maintenance Foreman		\$	
	Hrs. Water Maint. Man - 1 at		\$	
	Hrs. Water Maint. Man - 2 at		\$	
	Hrs. Garage Foreman	at	\$	
	Hrs. Labor	at	\$	
	Hrs. Compressor at		\$	
			\$	
	Trucking		\$	
	Pav't Patch		\$	
			\$	
			\$	
St. 428  
 Ave. No. 428  
 Name of Owner GLEN

Labor and Mat'l. Report 1922, JULY 21

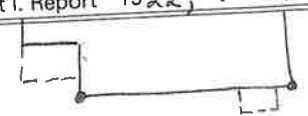

42'0" 48'0"

