

LABOR AND MATERIALS


1	Copper	Lead	Connection	\$	
1	Curb	Cock	_____ in.	\$	
	Service box	Short 3-1/2 x 4-1/2		\$	
	Old returned	Long 4-1/2 x 5-1/2		\$	
10	Ft.	11 in.	Copper G.I. Pipe at	\$	
	Nipples	_____ in.	at	\$	
	Bushings	_____ to _____ in.	at	\$	
	Red'g				
	Inc'g				
	Union	_____ in.	at	\$	
	Meter	_____ in.	at	\$	
	Compound Joints	at		\$	
	Maintenance Foreman			\$	
	Hrs. Water Maint. Man - 1	at		\$	
	Hrs. Water Maint. Man - 2	at		\$	
	Hrs. Garage Foreman	at		\$	
	Hrs. Labor	at		\$	
	Hrs. Compressor	at		\$	
	Trucking			\$	
	Pav't Patch			\$	
				\$	
				\$	
GLEN

St. Ave. No. 437-439

Name of Owner

Labor and Mat'l. Report 1926, JULY 14

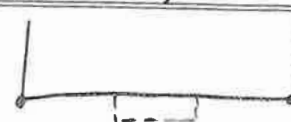

43'8" 36'

● Curb Box

14" Main

Elev. of Main at tap

Gate at ●

● Gate at

TAX ID # 302.20-6-21

● Curb Box

TAP MADE APRIL, 1924