


LABOR AND MATERIALS

1	Copper } Connection	3/4	\$
1	Lead } Cock Valve } T.C. & V.	3/4 in.	\$
1	Service box } Old returned	{ Short 3-1/2 x 4-1/2 } { Long 4-1/2 x 5-1/2 }	\$
18	Ft. 3/4 in. } Copper } Pipe at		\$
	Nipples	in. at	\$
	Bushings	to in. at	\$
	Red'g		
	Inc'g		
	Union	in. at	\$
	Meter	in. at	\$
			\$
	Compound Joints at		\$
	Maintenance Foreman		\$
	Hrs. Water Maint. Man - 1 at		\$
	Hrs. Water Maint. Man - 2 at		\$
	Hrs. Garage Foreman	at	\$
	Hrs. Labor	at	\$
	Hrs. Compressor at		\$
			\$
	Trucking		\$
	Pav't Patch		\$
			\$
			\$
			\$
			\$

St. **GLEN**
 Ave. No. **441-443**
 Name of Owner

Labor and Mat'l. Report 1932, AUG. 22

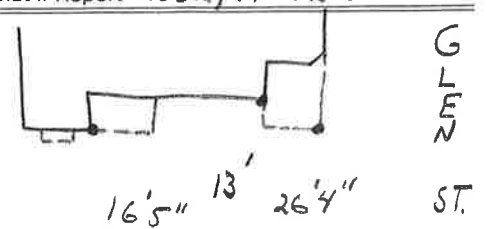

● Curb Box
BIRCH AVE
 4" Main Elev. of Main at tap 4'
 Gate at ● ● Gate at

● Curb Box
 OLD TAP SHUT OFF
 CURB BOX INSIDE OF SWK
 TAP ON BIRCH AVE