


LABOR AND MATERIALS

1	Copper } Connection	$\frac{3}{4}$	\$
1	Curb } Cock	$\frac{3}{4}$ in.	\$
1	Service box { Short 3-1/2 x 4-1/2 }		\$
	Old returned { Long 4-1/2 x 5-1/2 }		\$
9	Ft. $\frac{3}{4}$ in. { Copper }	Pipe at	\$
	Nipples	in. at	\$
	Bushings	to in. at	\$
	Red'g		
	Inc'g		
	Union	in. at	\$
	Meter	in. at	\$
			\$
	Compound Joints at		\$
	Maintenance Foreman		\$
	Hrs. Water Maint. Man - 1 at		\$
	Hrs. Water Maint. Man - 2 at		\$
	Hrs. Garage Foreman	at	\$
	Hrs. Labor	at	\$
	Hrs. Compressor at		\$
			\$
	Trucking		\$
	Pav't Patch		\$
			\$
			\$
St. GLEN
 Ave. No. 447

Name of Owner
O'KEEFE

Labor and Mat'l. Report 1948, JULY

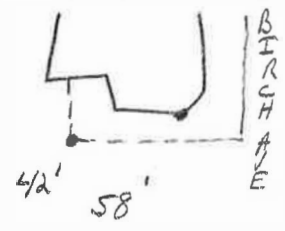

● Curb Box

12" Main
 GLEN ST.
 Elev. of Main at tap 5'

Gate at ● ● Gate at

TAX ID # 302.16-18-10

● Curb Box