


LABOR AND MATERIALS

1	Copper lead	} Connection	3/4	\$	_____		
1	Curb			} Cock Valve To Curb	3/4 in.	\$	_____
1	Service box	{ Short 3-1/2 x 4-1/2	}			\$	_____
	Old returned			{ Long 4-1/2 x 5-1/2	}	\$	_____
11	Ft.	} Copper	3/4 in.	}	Pipe at	\$	_____
	Nipples					in. at	\$
	Bushings	to	in. at	\$	_____		
	Red'g			\$	_____		
	Inc'g			\$	_____		
	Union	in. at		\$	_____		
	Meter	in. at		\$	_____		
				\$	_____		
	Compound Joints at			\$	_____		
	Maintenance Foreman			\$	_____		
	Hrs. Water Maint. Man - 1 at			\$	_____		
	Hrs. Water Maint. Man - 2 at			\$	_____		
	Hrs. Garage Foreman	at		\$	_____		
	Hrs. Labor	at		\$	_____		
	Hrs. Compressor at			\$	_____		
				\$	_____		
	Trucking			\$	_____		
	Pav't Patch			\$	_____		
				\$	_____		
				\$	_____		
				\$	_____		
				\$	_____		

St. GLEN
 Ave. No. 461
 Name of Owner _____

Labor and Mat'l. Report 1930, APR. 7

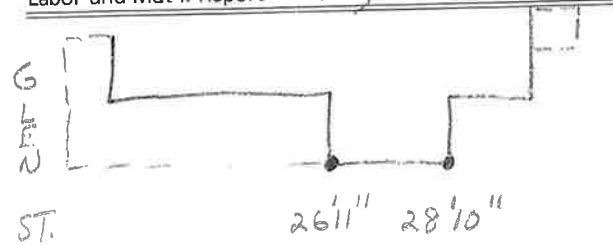

ST. 26'11" 28'10"
 ● Curb Box
CHESTER ST.
12" Main Elev. of Main at tap 5 1/2'

Gate at ● Gate at ●

● Curb Box
 OLD TAP DISCONNECTED
 TAP ON CHESTER ST.