


LABOR AND MATERIALS

Copper } Connection _____	\$ _____
Lead } _____	\$ _____
Curb } Cock _____	\$ _____
} Valve _____	in. _____
} T. S. & V. _____	\$ _____
Service box } Short 3½ x 4½ _____	\$ _____
Old returned } Long 4½ x 5½ _____	\$ _____
} Buff or Rdway _____	\$ _____
17'9" Ft. ¾ in. } Copper _____	\$ _____
} G. I. _____	\$ _____
} G. I. _____	\$ _____
Nipples _____ in. at _____	\$ _____
Bushings _____ to _____ in. at _____	\$ _____
Red'g } _____	\$ _____
Inc'g } Coupl'gs _____ to _____ in. at _____	\$ _____
Union _____ in. at _____	\$ _____
Meter _____ in. at _____	\$ _____
Lead Joints at _____	\$ _____
Compound Joints at _____	\$ _____
Maintenance Foreman _____	\$ _____
Hrs. Water Maint. Man—1 at _____	\$ _____
Hrs. Water Maint. Man—2 at _____	\$ _____
Hrs. Garage Foreman _____ at _____	\$ _____
Hrs. Labor— _____ at _____	\$ _____
Hrs. Compressor at _____	\$ _____
Compensation Ins. at \$ _____ per C _____	\$ _____
Trucking _____	\$ _____
Pav't Patch _____	\$ _____
_____	\$ _____
_____	\$ _____
_____	\$ _____
O'head _____	\$ _____
_____	\$ _____

Glen St. _____
 Ave. No. 471

Name of Owner _____
 TAX ID # 302.16-11-33

Labor and Mat'l. Report *aug* 19 *87*

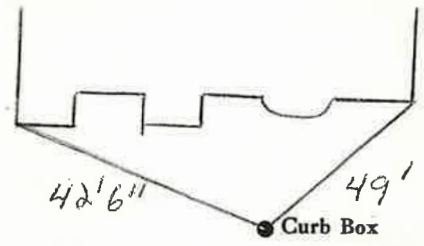

Main _____ Elev. of Main at tap _____
 Gate at • _____ Gate at _____

• Curb Box

Raja on Jefferson