

# LABOR AND MATERIALS


1	Copper Lead	Connection	3/4	\$
1	Curb Valve	1" in.		\$
1	Service box	Short 3-1/2 x 4-1/2		\$
	Old returned	Long 4-1/2 x 5-1/2		\$
8	Ft. 1" in.	Copper G.I. Pipe		\$
	Nipples	in. at		\$
	Bushings	to in. at		\$
	Red'g			
	Inc'g			
	Union	in. at		\$
	Meter	in. at		\$
	Compound Joints	at		\$
	Maintenance Foreman			\$
	Hrs. Water Maint. Man - 1	at		\$
	Hrs. Water Maint. Man - 2	at		\$
	Hrs. Garage Foreman	at		\$
	Hrs. Labor	at		\$
	Hrs. Compressor	at		\$
	Trucking			\$
	Pav't Patch			\$
				\$
				\$
St. GLEN No. 475 AB

Name of Owner \_\_\_\_\_

TAX ID # 302.16-10-8

Labor and Mat'l. Report 19 23, APR. 20

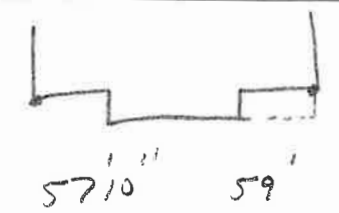

● Curb Box

16" Main Elev. of Main at tap 4'

Gate at ● ● Gate at

● Curb Box