


LABOR AND MATERIALS

Copper	{	Connection	\$
Lead			\$
Curb	{	Cock Valve	\$
		T. S. & V.	\$
Service box	{	Short 3½x4½	\$
Old returned		Long 4½x5½	\$
		Buff or Rdway	\$
Ft.	{	Copper	\$
in.		G. I.	\$
		C. I.	\$
Nipples	in.	at	\$
Bushings	to	in. at	\$
Red'g	{	Coupl'gs	\$
Inc'g		to	in. at
Union	in.	at	\$
Meter	in.	at	\$
Lead Joints	at		\$
Compound Joints	at		\$
Hrs. Water Maint. Man	—1 at		\$
Hrs. Water Maint. Man	—2 at		\$
Hrs. Labor	at		\$
Hrs. Labor	at		\$
Hrs. Compressor	at		\$
Compensation Ins.	at \$	per C.	\$
Trucking			\$
Pav't Patch			\$
			\$
			\$
O'head			\$
			\$

St. 78
Pl. 78
Ave. No. 78

Name of Owner Spectors
Measured in 12-21-51
Labor and Mat'l. Report 19

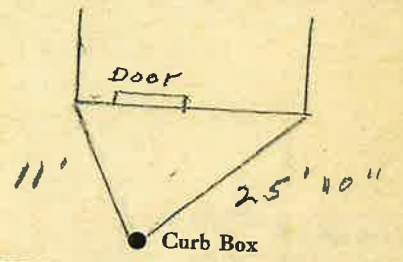

Main Elev. of

Gate at ● ● Gate at

● Curb Box