

LABOR AND MATERIALS


1	Copper } Connection	3/4"	\$
1	Curb } Cock Valve } T.O. & V.	3/4 in.	\$
1	Service box } Old returned	{ Short 3-1/2 x 4-1/2 } { Long 4-1/2 x 5-1/2 }	\$
12	Ft. } Copper } Pipe at	3/4 in.	\$
	Nipples	_____ in. at _____	\$
	Bushings	_____ to _____ in. at _____	\$
	Red'g		
	Inc'g		
	Union	_____ in. at _____	\$
	Meter	_____ in. at _____	\$
			\$
	Compound Joints at		\$
	Maintenance Foreman		\$
	Hrs. Water Maint. Man - 1 at		\$
	Hrs. Water Maint. Man - 2 at		\$
	Hrs. Garage Foreman	_____ at _____	\$
	Hrs. Labor	_____ at _____	\$
	Hrs. Compressor at		\$
			\$
	Trucking		\$
	Pav't Patch		\$
			\$
			\$
GLEN

St. No. 488

Name of Owner

Labor and Mat'l. Report 19 35, Oct. 5

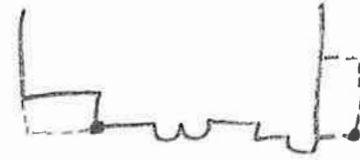

46'7" 71'5"

● Curb Box

GRANT AVE

4" Main

Elev. of Main at tap 42'

Gate at ●

12 3/4' to main

● Gate at

● Curb Box

OLD TAP SHUT OFF AT MAIN

TAX ID # 302.15-14-1