

# LABOR AND MATERIALS


1	Copper } Connection	1	\$
1	Lead } Cock		
1	Curb } Valve	1	in. \$
1	Service box { Short 3-1/2 x 4-1/2	1	\$
	Old returned { Long 4-1/2 x 5-1/2		
37	Ft. 1" { Copper		
	in. } Pipe at		\$
	Nipples		in. at \$
	Bushings		to in. at \$
	Red'g		
	Inc'g		
	Union		in. at \$
	Meter		in. at \$
			\$
	Compound Joints at		\$
	Maintenance Foreman		\$
	Hrs. Water Maint. Man - 1 at		\$
	Hrs. Water Maint. Man - 2 at		\$
	Hrs. Garage Foreman		at \$
	Hrs. Labor		at \$
	Hrs. Compressor at		\$
			\$
	Trucking		\$
	Pav't Patch		\$
			\$
			\$
Glen

St. Ave. No. 492 A+B

Name of Owner

Labor and Mat'l. Report 19 29, Sept. 21

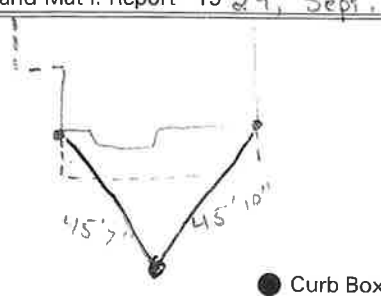

16 Main Elev. of Main at tap 4 1/2

Gate at ● Gate at ●

● Curb Box

OLD TAP SHUT OFF