


LABOR AND MATERIALS

1	Copper	} Connection	1"	\$	
1	Lead			\$	
1	Curb	} Cock Valve T. S. & V.	1 in. Oriseal	\$	
1	Service box		} Short 3 1/2 x 4 1/2 Long 4 1/2 x 5 1/2 Buff or Rdway		\$
	Old returned				\$
10	Ft. /	} Copper C.I. C.I.	Pipe at	\$	
				\$	
				\$	
	Nipples	in. at		\$	
	Bushings	to in. at		\$	
	Red'g } Inc'g }	Coupl'gs	to in. at	\$	
	Union	in. at		\$	
	Meter	in. at		\$	
	Lead Joints	at		\$	
	Compound Joints	at		\$	
	Maintenance Foreman			\$	
	Hrs. Water Maint. Man	—1 at		\$	
	Hrs. Water Maint. Man	—2 at		\$	
	Hrs. Garage Foreman	at		\$	
	Hrs. Labor	at		\$	
	Hrs. Compressor	at		\$	
	Compensation Ins.	at \$ per C		\$	
	Trucking			\$	
	Pav't Patch			\$	
	Tap by Giggard			\$	
	& Cb.	10-14-64		\$	
	O'head			\$	

Glen St. Pl. Ave. No. 493

Name of Owner McPhillips

Labor and Mat'l. Report Oct, 14 1964

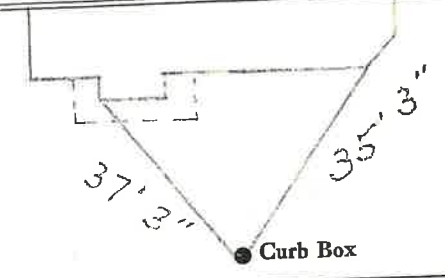

16" Main Elev. of Main at tap 5'

Gate at • Gate at •

• Curb Box