


LABOR AND MATERIALS

1	Copper } Connection	1/2"	\$
1	Lead } Curb	3/4" in.	\$
	Cock Valve } T.S. & V.		
1	Service box	{ Short 3-1/2 x 4-1/2 }	\$
	Old returned	{ Long 4-1/2 x 5-1/2 }	\$
8	Ft. 3/4 in. { Copper } Pipe at	G.I.	\$
	Nipples	in. at	\$
	Bushings	to in. at	\$
	Red'g		
	Inc'g		
	Union	in. at	\$
	Meter	in. at	\$
			\$
	Compound Joints at		\$
	Maintenance Foreman		\$
	Hrs. Water Maint. Man - 1 at		\$
	Hrs. Water Maint. Man - 2 at		\$
	Hrs. Garage Foreman	at	\$
	Hrs. Labor	at	\$
	Hrs. Compressor at		\$
			\$
	Trucking		\$
	Pav't Patch		\$
			\$
			\$
St. Glen
 Ave No. 497

Name of Owner G. Ferguson

Labor and Mat'l. Report 19 23, May 9

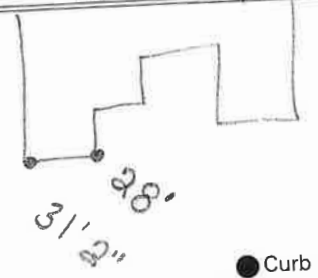

_____ Main
 Elev. of Main at tap _____
 Gate at ● Gate at ●

TAX ID # 302.16-2-14

● Curb Box