


LABOR AND MATERIALS

1	Copper	Connection } $3/4''$	\$	
1	Lead			
1	Curb	Cock } $3/4''$ in.	\$	
			Valve } T.S. & V.	
1	Service box	Short $3\frac{1}{2} \times 4\frac{1}{2}$	\$	
	Old returned			Long $4\frac{1}{2} \times 5\frac{1}{2}$
				Buff or Rdway
37	Ft. $3/4''$ in.	{ Copper } Pipe at	\$	
		{ G.I. }		
		{ C.I. }		
	Nipples	in. at	\$	
	Bushings	to in. at	\$	
	Red'g } Inc'g }	Coupl'gs to in. at	\$	
	Union	in. at	\$	
	Meter	in. at	\$	
	Lead Joints	at	\$	
	Compound Joints	at	\$	
	Maintenance Foreman		\$	
	Hrs. Water Maint. Man—1	at	\$	
	Hrs. Water Maint. Man—2	at	\$	
	Hrs. Garage Foreman	at	\$	
	Hrs. Labor—	at	\$	
	Hrs. Compressor	at	\$	
	Compensation Ins. at \$	per C	\$	
	Trucking		\$	
	Pav't Patch		\$	
	Tap by Miller & Co.		\$	
	10-30-57		\$	
	O'head		\$	
			\$	

St.   
 -Pl-   
 Ave. No. 498

Name of Owner   
 Dr. John Stark

Labor and Mat'l. Report Oct. 30 1957

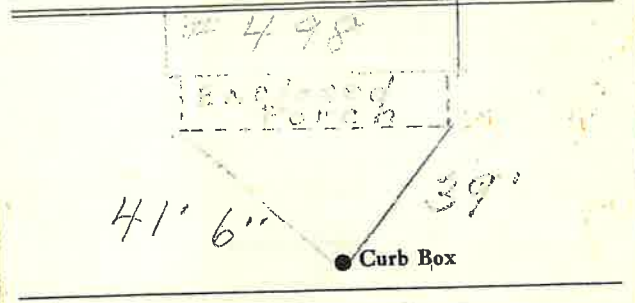

1 1/2" Main   
 Elev. of Main at tap  $5\frac{1}{2}'$

Gate at • • Gate at

• Curb Box