


LABOR AND MATERIALS

1 Copper Lead	Connection	3/4"			\$
1 Curb	Cock Valve	3/4 in.	Oriseal.		\$
	T. S. & V.				\$
1 Service box	Old returned	Short 3 1/2 x 4 1/2			\$
		Long 4 1/2 x 5 1/2			\$
		Buff or Rdway			\$
38 Ft.	3/4 in.	Copper G. I. C. I.	Pipe at		\$
					\$
					\$
	Nipples	in. at			\$
	Bushings	to in. at			\$
	Red'g Inc'g	Coupl'gs	to in. at		\$
					\$
	Union	in. at			\$
	Meter	in. at			\$
	Lead Joints	at			\$
	Compound Joints	at			\$
	Maintenance Foreman				\$
	Hrs. Water Maint. Man-1	at			\$
	Hrs. Water Maint. Man-2	at			\$
	Hrs. Garage Foreman	at			\$
	Hrs. Labor	at			\$
	Hrs. Compressor	at			\$
	Compensation Ins.	at \$	per C		\$
	Trucking				\$
	Pav't Patch				\$
	Tap by Gifford & Co.				\$
					\$
					\$
	O'head				\$

St. Glen
~~Pl.~~
 Ave. No. 504

Name of Owner Winston Judd

Labor and Mat'l. Report 5-23-1968

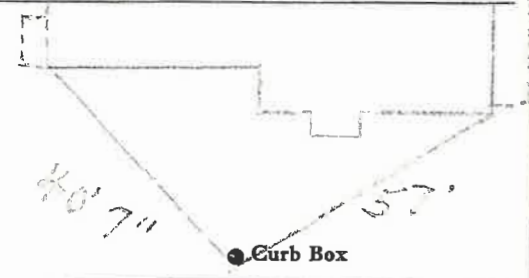

Lincoln Ave.
 Elev. of Main at tap 4'

Gate at ● ● Gate at

● Curb Box
 This Tap on Lincoln Ave.

40' 7" 57'

This tap on Lincoln Ave