


LABOR AND MATERIALS

| | | | |
|---|---------------------------------|--|----|
| 1 | Copper lead } Connection | 3/4 | \$ |
| 1 | Curb } Cock Valve } T.S. & W. } | 3/4 in. orisea | \$ |
| 1 | Service box } Old returned } | Short 3-1/2 x 4-1/2 } Long 4-1/2 x 5-1/2 } | \$ |
| 8 | Ft. 3/4 in. } Copper St. St. } | Pipe at | \$ |
| | Nipples | in. at | \$ |
| | Bushings | to in. at | \$ |
| | Red'g | | |
| | Inc'g | | |
| | Union | in. at | \$ |
| | Meter | in. at | \$ |
| | Compound Joints | at | \$ |
| | Maintenance Foreman | | \$ |
| | Hrs. Water Maint. Man - 1 | at | \$ |
| | Hrs. Water Maint. Man - 2 | at | \$ |
| | Hrs. Garage Foreman | at | \$ |
| | Hrs. Labor | at | \$ |
| | Hrs. Compressor | at | \$ |
| | Trucking | | \$ |
| | Pav't Patch | | \$ |
| | Tap by St. John & Co. | | \$ |
| | Feb. 20, 1976 | | \$ |

Glen St. No. 505

Name of Owner Saul Goldman

Labor and Mat'l. Report 19 76, Feb. 20

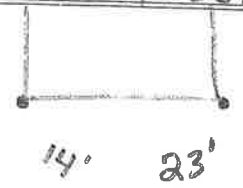

● Curb Box

12" Main Elev. of Main at tap 5'

Gate at ● Gate at ●

● Curb Box

NOTE: Curb box is in front lawn - 18' from curb